

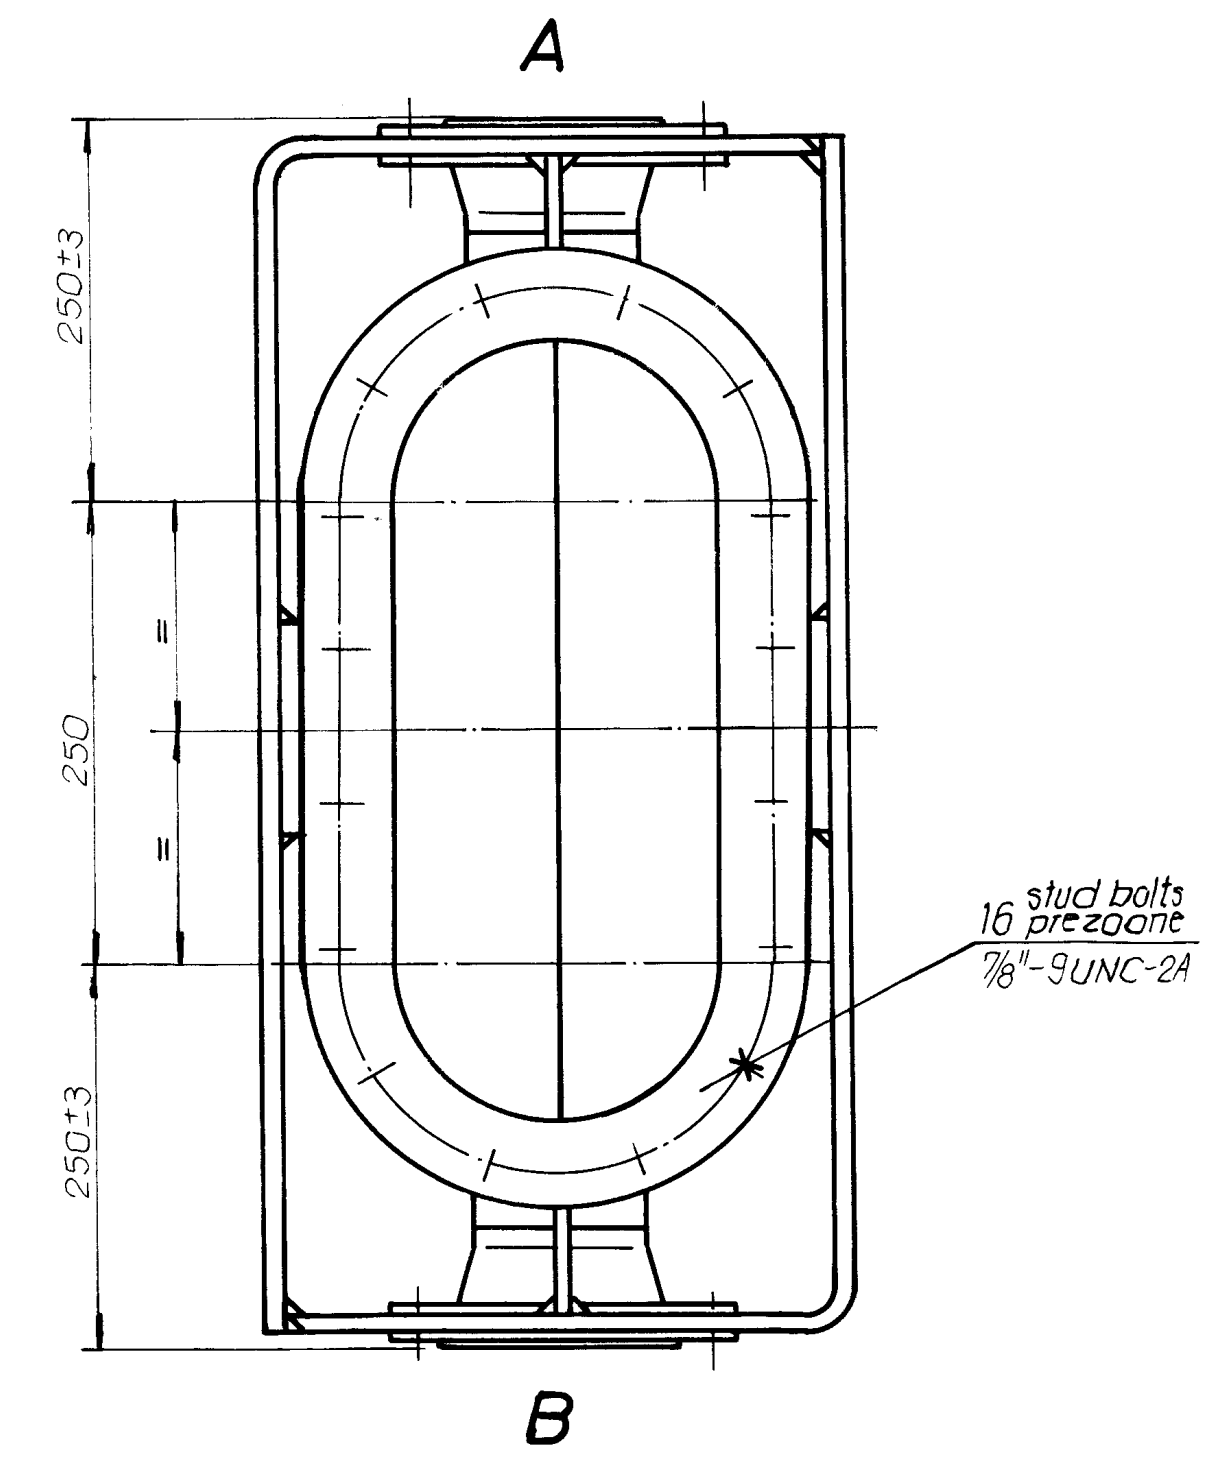
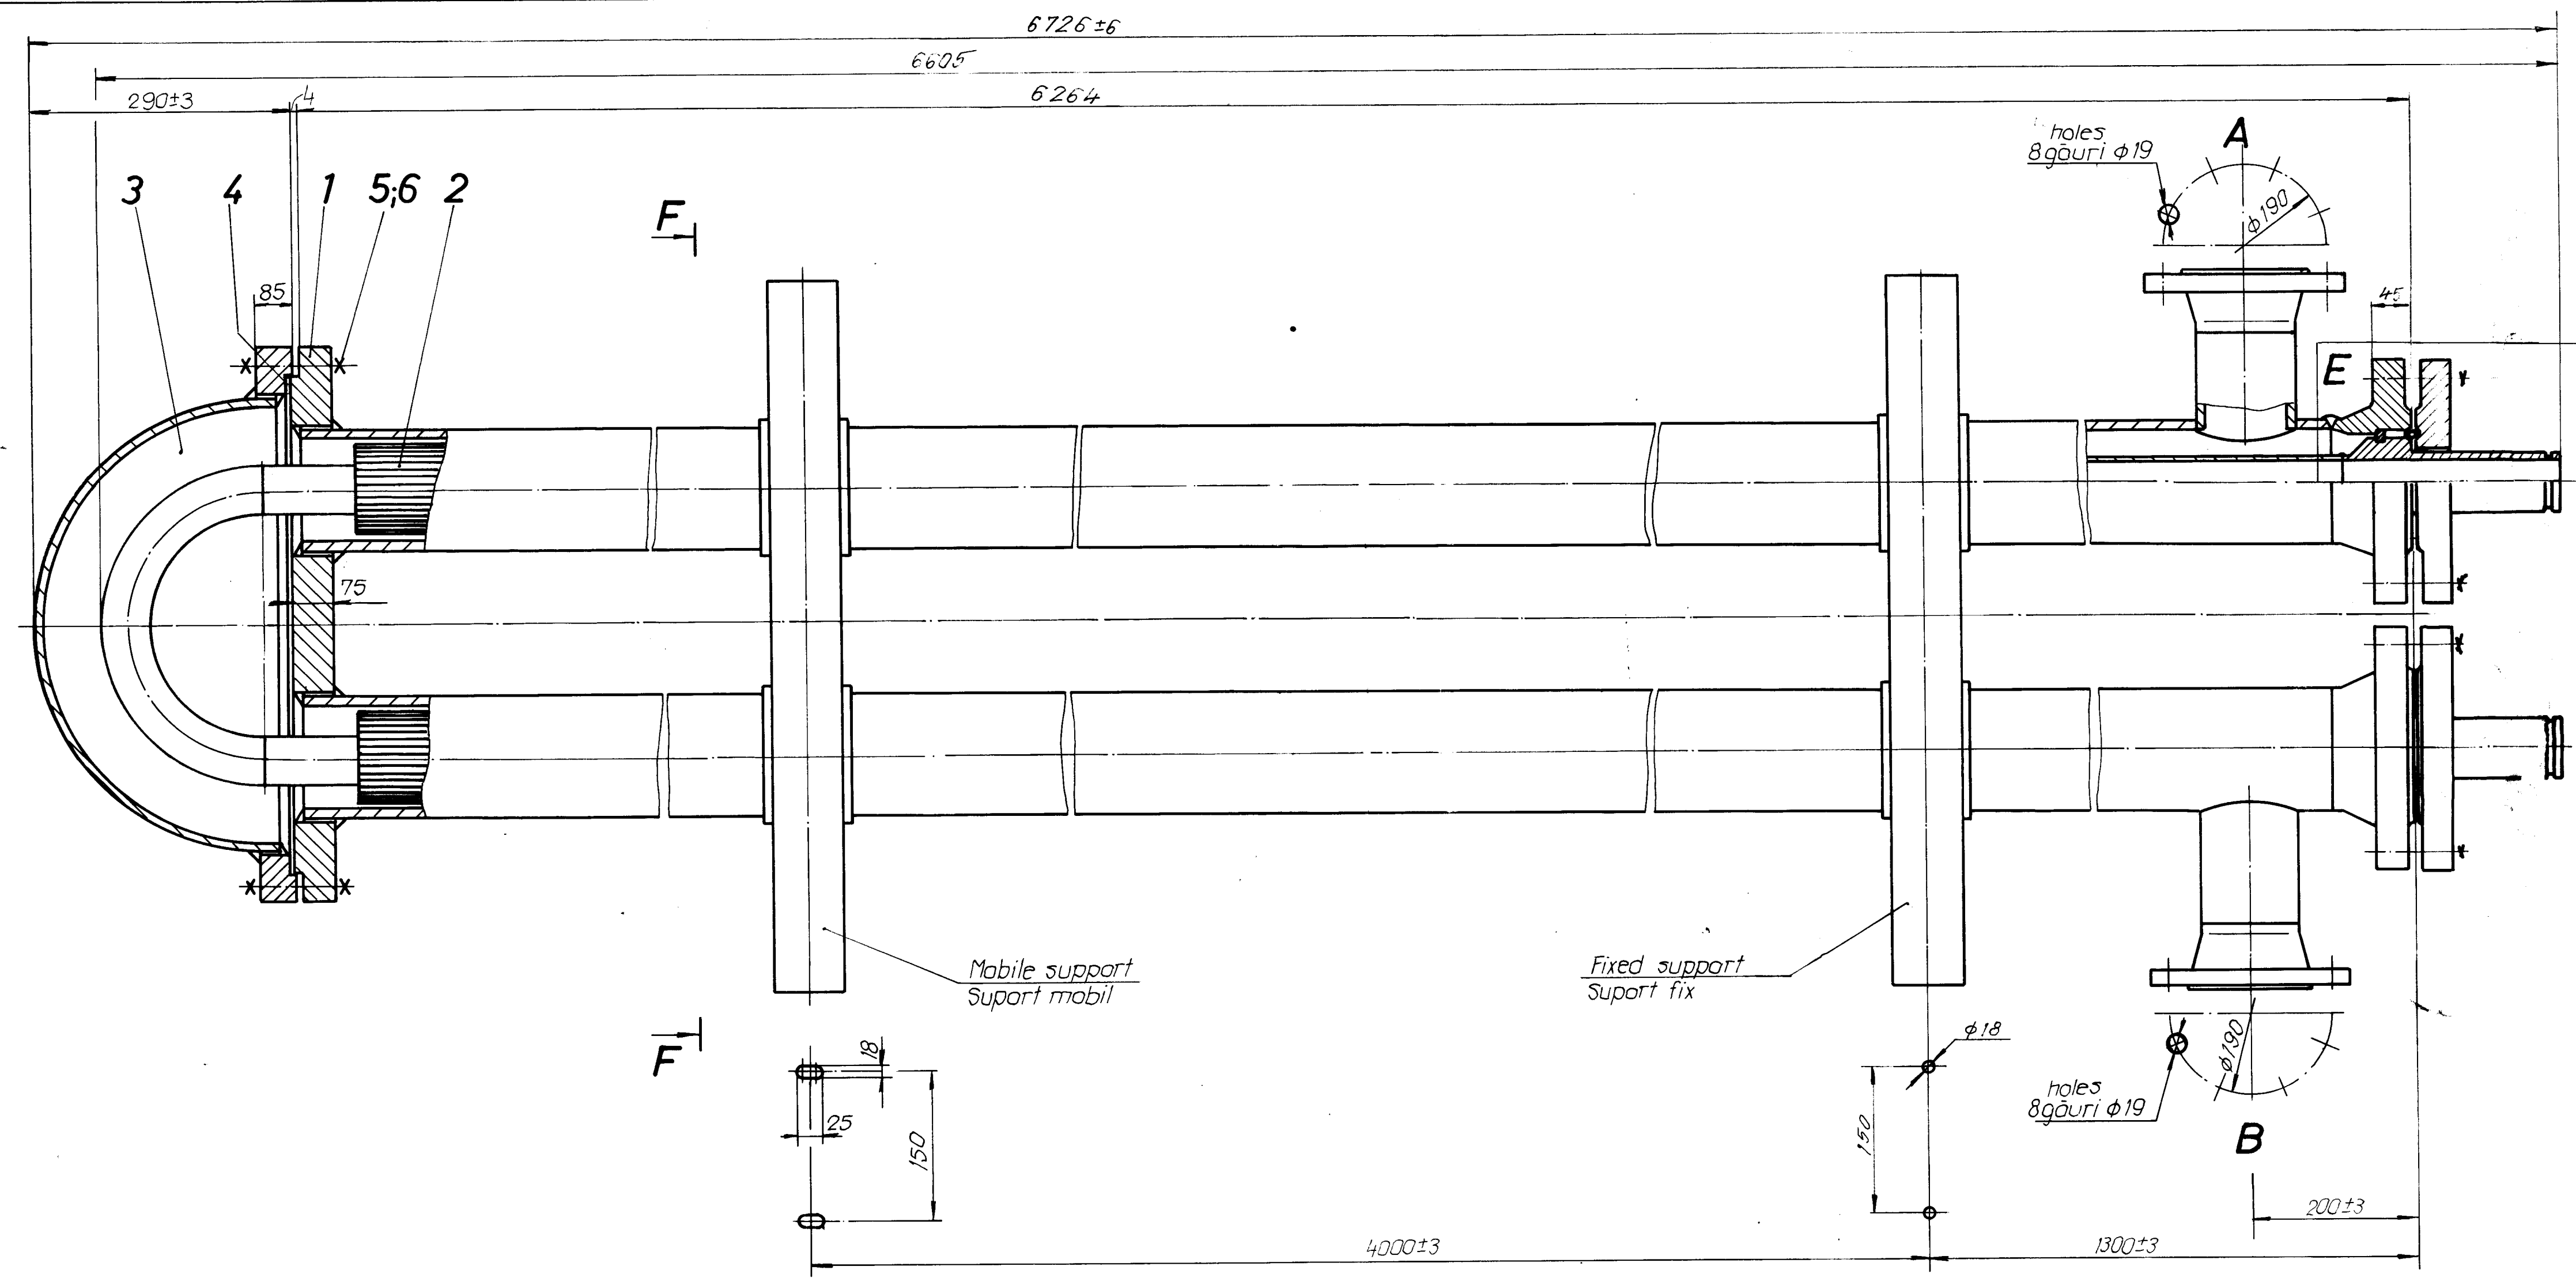


# ITEM # 1 - 309-E-1 INTERCOOLER ASSEMBLY

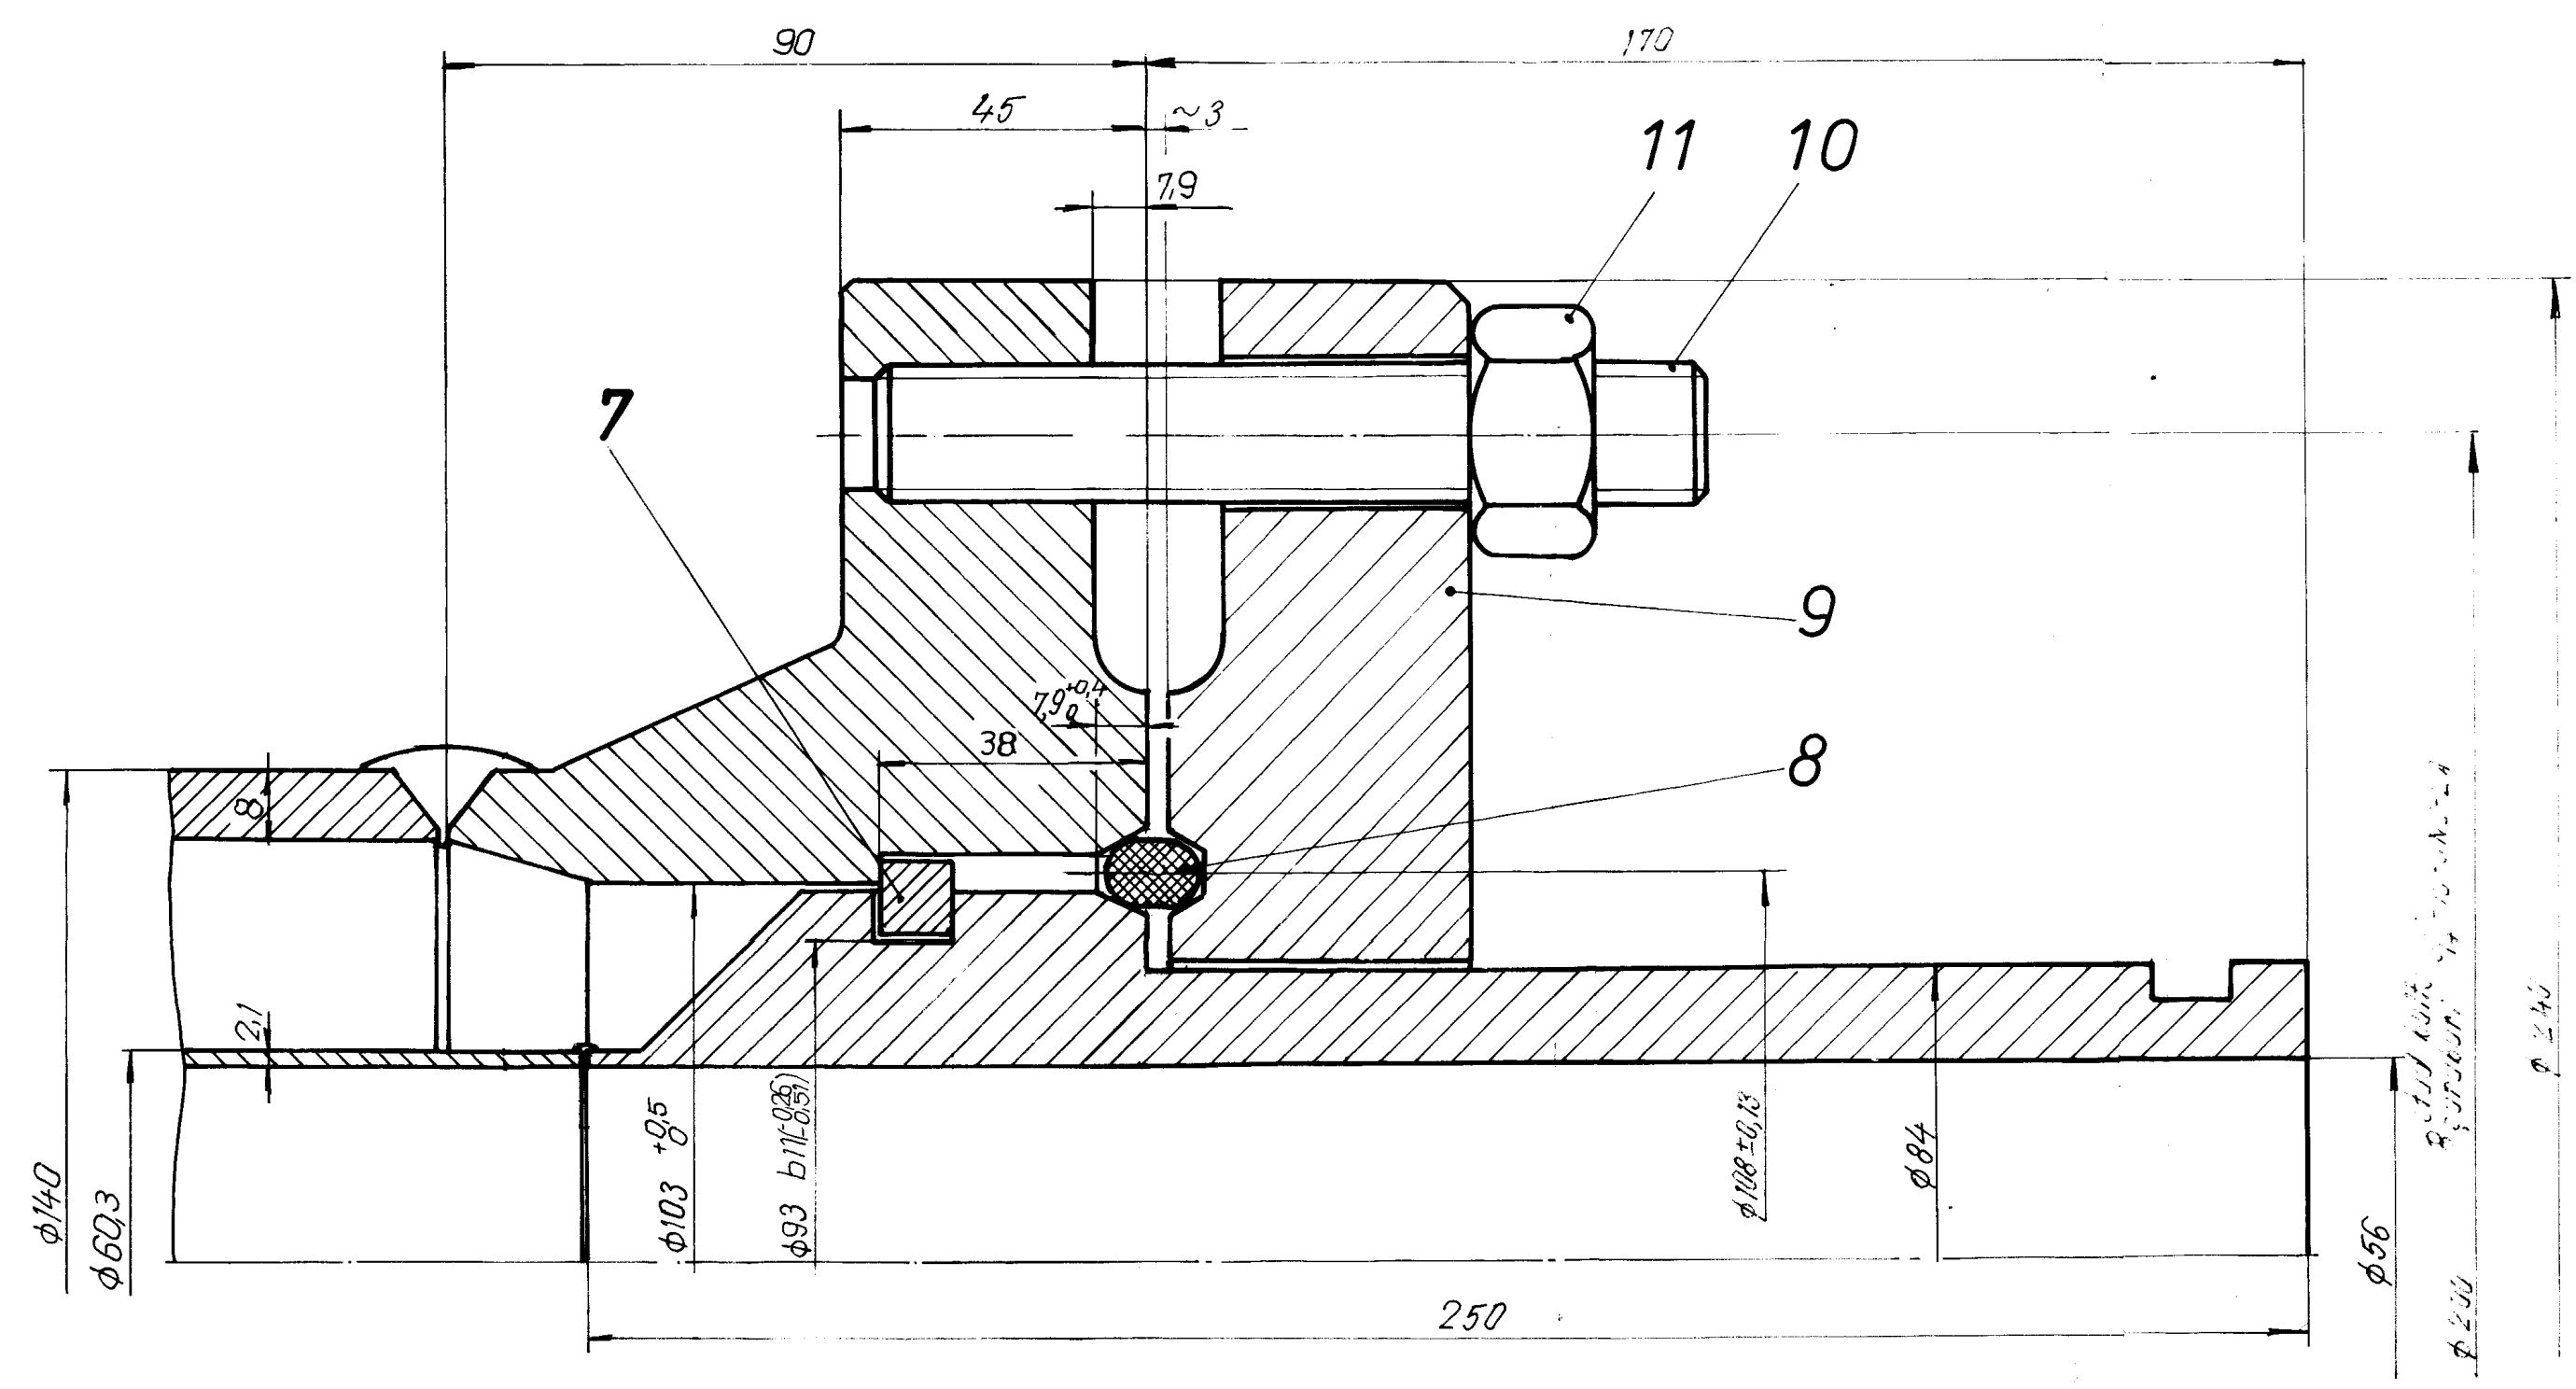

Section  
Secțiunea F-F  
Scale: 1:5  
Scara: 1:5

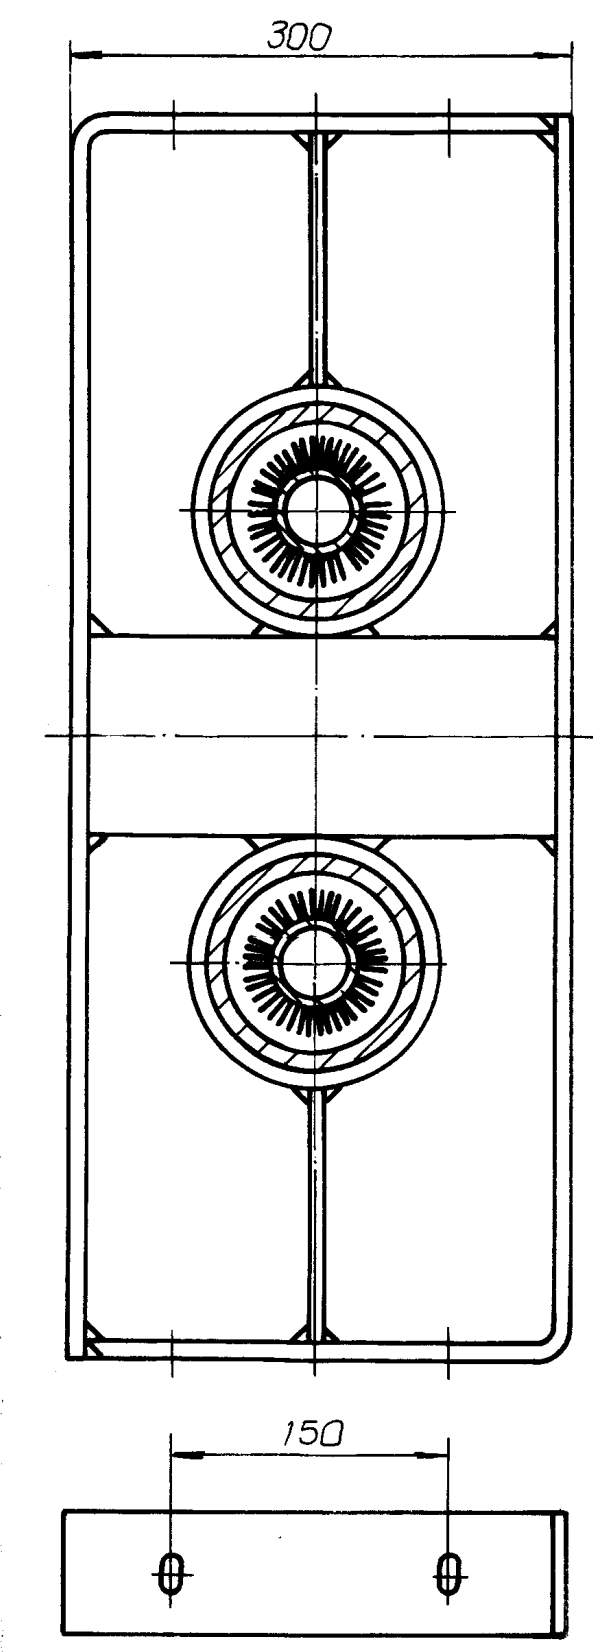

E Scale: 1:1  
Scara: 1:1

| Item No. | Part name / Descrierea  | Qty | Unit | Material | Remarks | Weight |
|----------|---|-----|------|----------|---------|--------|
| 11       | Hex nut / Piuliță 3/4"-10 UNC-2A                                  | 16  | PC   | 304      |         | 0,25   |
| 10       | Stud bolt / Prezon 3/4"-10 UNC-2A                                 | 16  | PC   | 304      |         | 0,29   |
| 9        | Flange / Flanșă   | 2   | PC   | 304      |         | 5,5    |
| 8        | Split ring / Inel din oțel jumătăți                               | 2   | PC   | 304      |         | 0,52   |
| 7        | Hex nut / Piuliță 7/8"-9 UNC-2B                                   | 32  | PC   | 304      |         | 0,26   |
| 6        | Stud bolt / Prezon 7/8"-9 UNC-2A                                  | 16  | PC   | 304      |         | 0,11   |
| 5        | Double jacketed asbestos filled gasket / Garnitură metaloplastică | 1   | PC   | 304      |         | 0,64   |
| 4        | Cover / Capac   | 1   | PC   | 304      |         | 0,56   |
| 3        | Element tube / Element tubular                                    | 1   | PC   | 304      |         | 63,00  |
| 2        | Shell / Corp  | 1   | PC   | 304      |         | 124,00 |
| 1        | Shell / Corp  | 1   | PC   | 304      |         | 480,00 |

JORDAN PETROLEUM REFINERY CO. LTD  
THIRD STAGE EXPANSION PROJECT

| No. | Revisions / Revizii | Date / Data | Approved / Aprobat | No. | Revisions / Revizii | Date / Data | Approved / Aprobat |
|-----|---------------------|-------------|--------------------|-----|---------------------|-------------|--------------------|
| 1   | As built            | 26.08.76    |                    | 1   | As built            | 26.08.76    |                    |
| 2   | Design              | 26.08.76    |                    | 2   | Design              | 26.08.76    |                    |
| 3   | Check               | 26.08.76    |                    | 3   | Check               | 26.08.76    |                    |
| 4   | Approved            | 26.08.76    |                    | 4   | Approved            | 26.08.76    |                    |

Job No. 309-E-1  
Scale: 1:5  
Net weight: 685,00 kg  
Gross weight: 748,00 kg  
ICPRP  
ROMANIAN RESEARCH AND DESIGN INSTITUTE FOR OIL REFINING AND PETROCHEMICAL INDUSTRIES  
PLOESTI-ROMANIA  
ELEM INTERCOOLER  
ELEMENȚ RACITOR  
Purchaser  
Order number



ITEM # 1 - 309-E-1  
SEALING BODY

